

- LEGEND:**
- Proposed Property Boundary
 - Existing Property Boundary
 - Proposed Easement
 - G1/1** Stormwater Gully Pit Label
 - M1/1** Stormwater Manhole Label
 - H1/1** Stormwater Headwall Label
 - F8/1** Field Inlet
 - G1/1** Future Stormwater Gully Pit Label
 - G1/1** Existing Stormwater Gully Pit Label
 - M1/1** Existing Stormwater Manhole Label
 - H1/1** Existing Stormwater Headwall Label
 - x KA** Kerb Adaptor to Site Authority Requirements
 - (D)---(D)--- Stormwater
 - CS Stormwater Connection Stub
 - Culvert
 - (D)---(D)--- Future Stormwater
 - (W)--- Water Main
 - (D)--- Existing Stormwater
 - █ Road Pavement
 - █ Existing Road Pavement
 - PL 601.570** Platform Level
 - Minor Contours
 - 609.00 Major Contours

- NOTES:**
- Intervals between contours - 0.2m
 - Refer drawing C-D0401, C-D0402 and C-D0403 for stormwater details.
 - Refer drawing C-D0403 for stormwater drainage notes.

STORMWATER LAYOUT PLAN

Scale 1:1000 (A1)

AS CONSTRUCTED NOTE:
 All as constructed survey information in relation to this drawing was provided to RMA by Allroads Pty Ltd which has been compared by RMA with the original drawing as to line, level & dimensions. It has been amended by RMA so as to constitute a record of the work as constructed as at April, 2019. RMA are not surveyors and the responsibility for the accuracy of the survey information provided remains with the Surveyor.


AS CONSTRUCTED WORKS
 It is certified that works herein have been constructed to local government standards, relevant approved specifications and the operational works approval. The as constructed drawings for these works constitute a true and correct record of the works constructed and complies with the design intent.

Signature: _____

AS CONSTRUCTED WORKS
 It is certified that the locations, levels and dimensions of the infrastructure shown herein are a true representation of the constructed works and that the as constructed survey was performed to the prescribed accuracy standards.

Registered/Licensed Surveyor's signature: _____ 15.05.2019

Company Title: Allroads

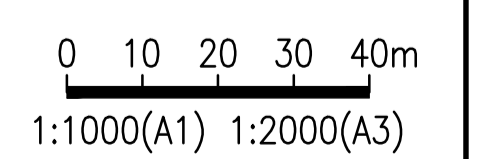

ISSUE	DESCRIPTION	DATE	DWN	DES	CHK	APP
4	AS CONSTRUCTED	26/04/19	AJO	RM	RM	JBH
3	FOR TENDER	23/08/18	NGT	JDP	JDP	JMW
2	FOR COUNCIL APPROVAL	28/02/18	ANB	JDP	JMW	JMW
1	FOR COUNCIL RFI DATED 13/09/17	28/10/17	JDP	JDP	JMW	JMW
0	FOR APPROVAL	21/08/17	NGT	JDP	JDP	JMW

NOTE: FIGURED DIMENSIONS TO TAKE PRECEDENCE OVER SCALED MEASUREMENTS. VERIFY ALL ON SITE DIMENSIONS & LEVELS PRIOR TO THE COMMENCEMENT OF ANY CONSTRUCTION. CONTRACTOR TO NOTIFY ENGINEER IMMEDIATELY OF ANY DISCREPANCIES. COPYRIGHT OF THIS DRAWING IS VESTED WITH RMA ENGINEERS PTY. LTD.



CLIENT
JETELD PTY LTD
 PO BOX 9109
 WILSONTON QLD 4350

PROJECT
29 LOT RURAL RESIDENTIAL SUBDIVISION (STAGE 1)
STEINBERG ROAD
HIGHFIELDS QLD 4352

TITLE
STORMWATER LAYOUT PLAN

PROJECT NO.
6886
 COUNCIL RAL/MCU NO.
RAL/2015/1814/A
 COUNCIL OW NO.
OW/2017/4397
 DRAWING NO.
C-D0201 ISSUE
4